


(97)

TANAH DAN

(BRSO COORDINATES)  
E: 2300704.359m  
N: 5306627.056m

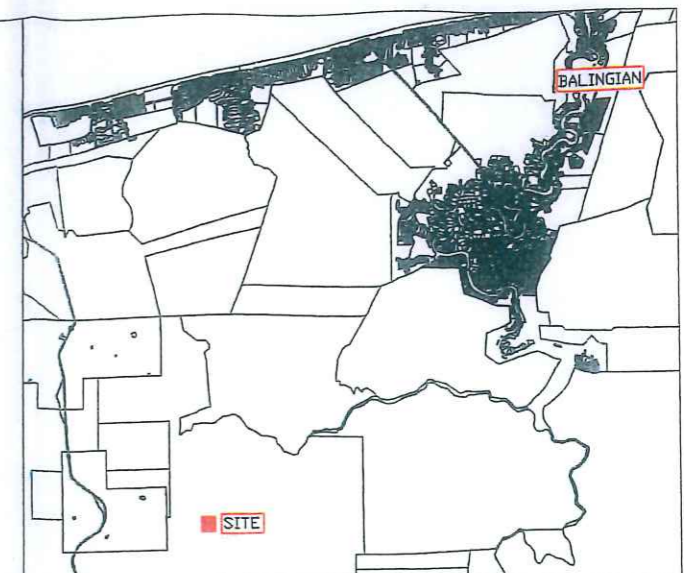

LOCALITY PLAN SCALE : 1:100000

- LEGEND
- SITE BOUNDARY (484m<sup>2</sup>)
  - 7.5 METERS ACCESS ROAD (232m<sup>2</sup>)  
(to be surrendered to the state free of all cost)
  - EXISTING TAR SEALED ROAD
  - - - EXISTING FENCING

AS BUILT PLAN

SUBMITTED BY : DATU SR SUDARSONO BIN OSMAN

SIGNATURE :

SPA REGISTRATION NO. : 020/2021




VALSA (SARAWAK) SDN. BHD.  
LOT 13325 (NO.9), 1ST FLOOR  
RIVEREDGE COMMERCIAL CENTRE,  
SECTION 85 KTD, JALAN MERDEKA,  
OFF JALAN ABD RAHMAN YAKUB,  
93050 KUCHING, SARAWAK  
Tel: 082-411845 Fax: 082-419845

THIS PLAN IS APPROVED BY THE DIRECTOR OF  
LANDS AND SURVEYS IN ACCORDANCE WITH  
SECTION 229(2) AND 234(1)(a) OF THE LAND CODE.  
THIS PLAN SHALL HEREINAFTER BE REFERRED TO AS  
"THE APPROVED PLAN"

REF: 2/TC/100/125/2022/JEN-1

DIRECTOR OF LANDS AND SURVEYS

DATE: 5/6/2024

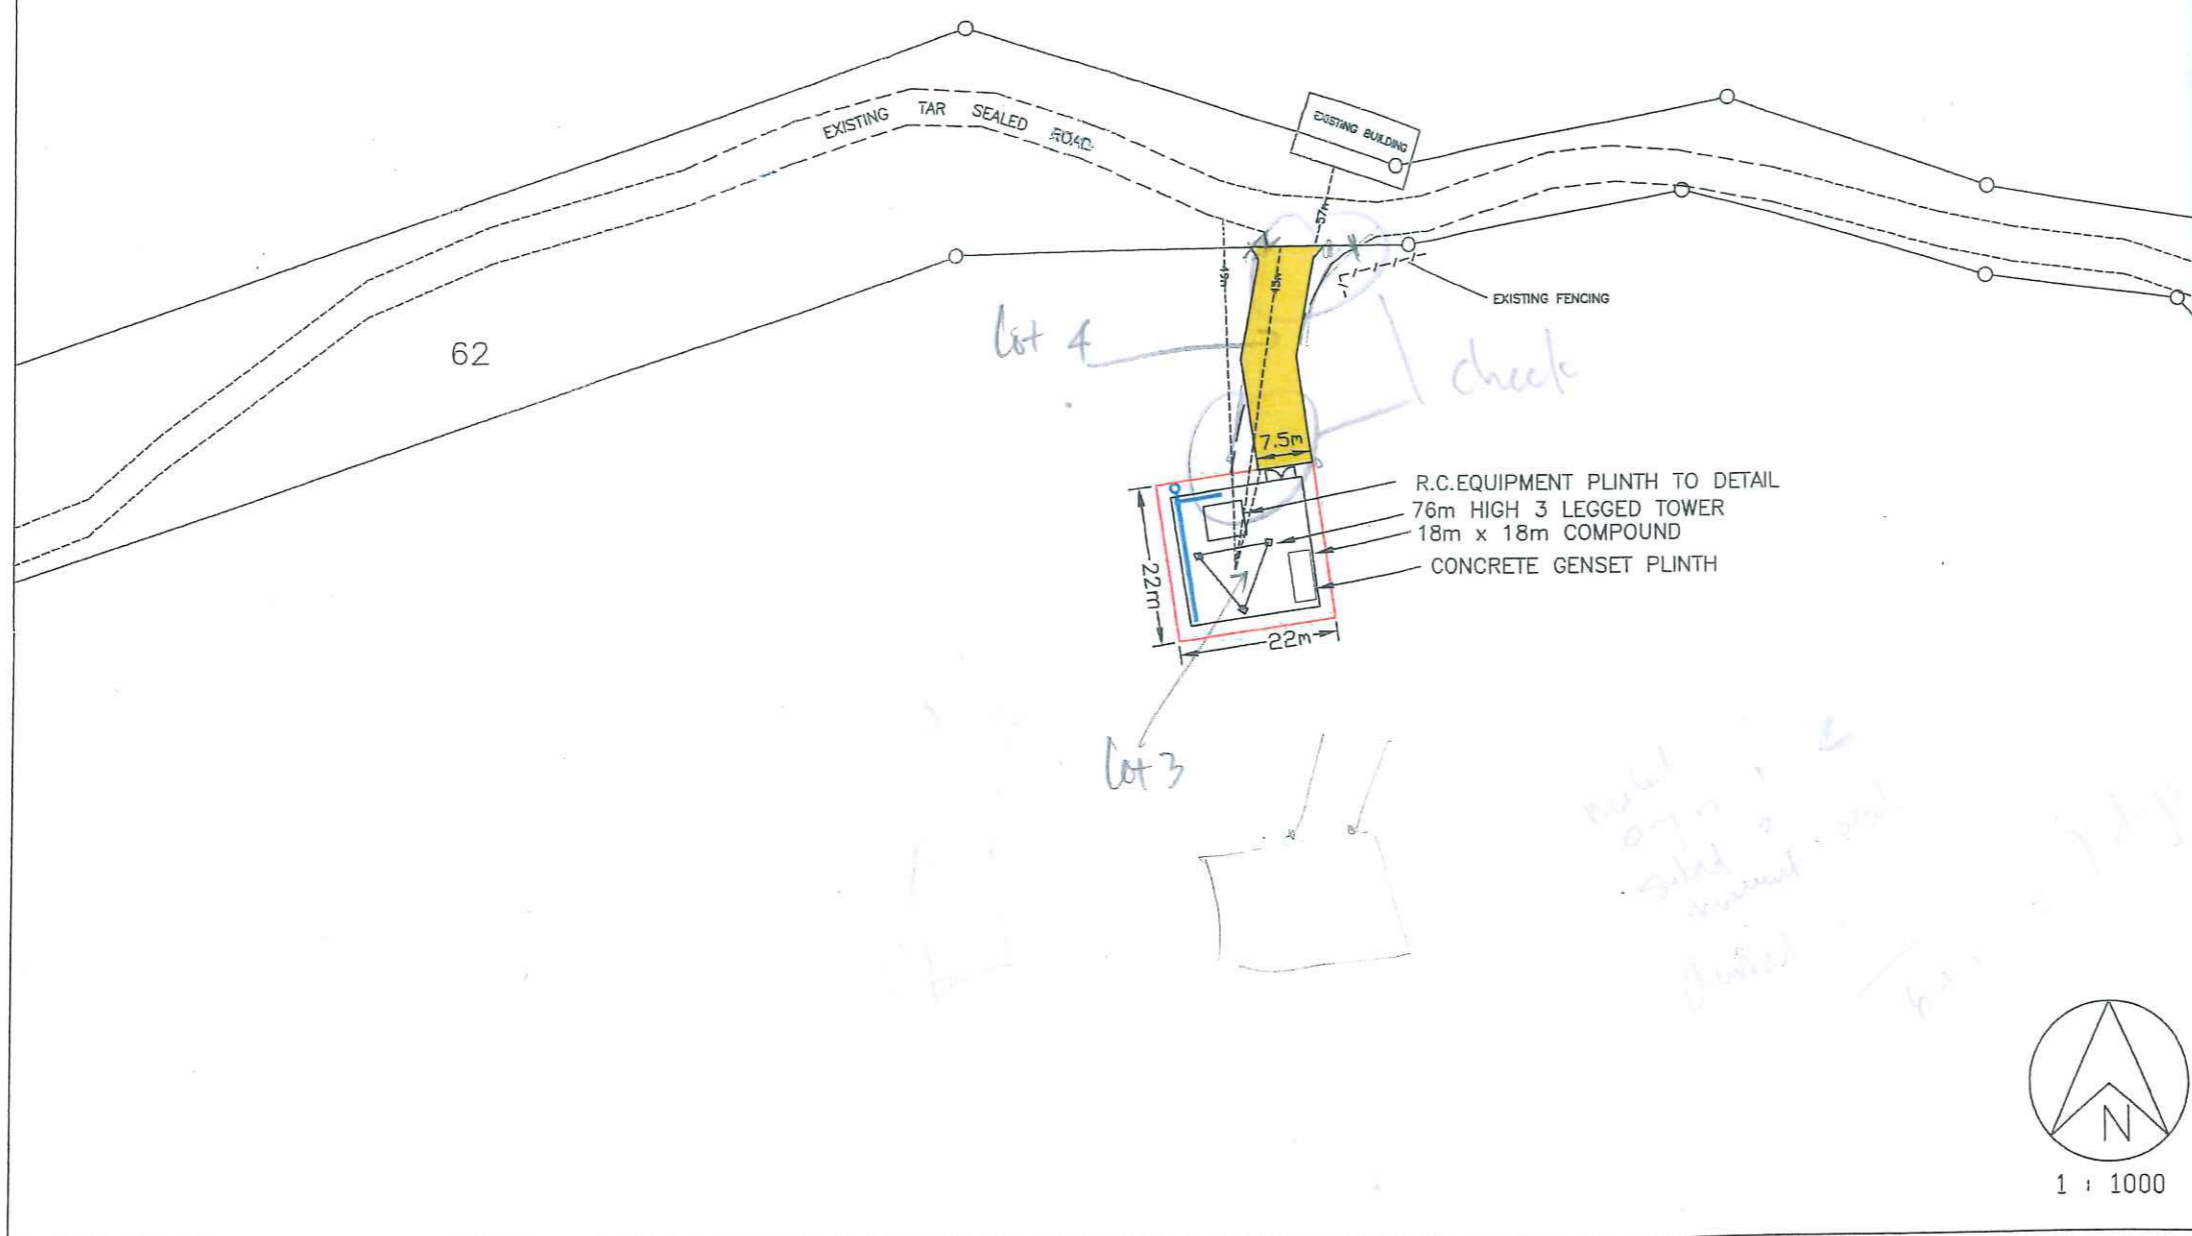

PROVISION AND IMPLEMENTATION OF THE JALINAN DIGITAL NEGARA (JENDELA) PHASE 1 (PART 1)  
PROJECT ON UNREGISTERED STATE LAND AT SK PENGKALAN LOBANG, BAWAN LAND DISTRICT, MUKAH DIVISION.  
SITE NAME : SK PENGKALAN LOBANG  
SITE ID : JEN1\_1366

DRAWING NO. : AG/JENDELA/2022/JEN1\_1366

DATE : 24 APRIL 2024